


ANDALUSIA, AL - FLOOR PLAN  
SCALE: 1/8" = 1'-0"

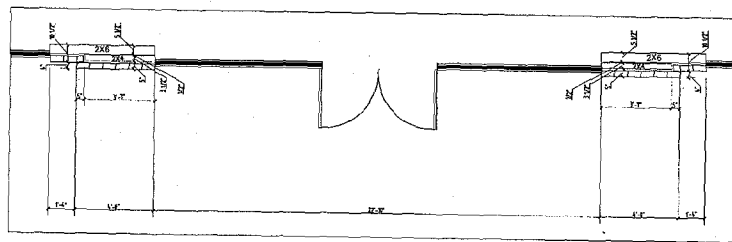

SIGNBASE BUMP OUT - ENLARGED FLOOR PLAN  
SCALE: 3/8" = 1'-0"


IRELAND  
ARCHITECTS

(517)278-3339

Andalusia Alabama Associates, LLC  
New Retail Center  
Andalusia, AL

Date 4/16/08  
4/29/08

Issued for PERMITS  
CONSTRUCTION

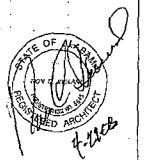

Sheet

A2.1